


#### BENCH MARKS

- State B.M - Pk in lead on concrete casing for M.H. 180' Elev. 812.29  
 North of S. intc. of Indiana & Monroe.  
 City B.M. - Pk in lead in calcite wall 1/4 East of east end Elev. 829.26  
 of abutment of R.R. bridge over Monroe.  
 T.B.M. - "X" Top of storm drain wly side Monroe, Elev. 819.32  
 1000' E South of Indiana.  
 T.B.M. - 20 penny spk. in P. Pole #12226 J. 80' E. cost. Elev. 813.99  
 of intc. of Indiana & Monroe, Nly side of Indiana.  
 T.B.M. - 20 penny spk. in P. Pole #8290 J. on sly side of Elev. 816.22  
 Indiana, 977' E. from intc. of Indiana & Monroe.  
 T.B.M. - 20 penny spk. in P. Pole #8293 J. sly side Indiana. Elev. 824.22  
 1450' E. from intc. of Indiana & Monroe.  
 T.B.M. - 20 penny spk. in P. Pole #2500 J. on S.E. corner of Elev. 834.42  
 intc. of Jackson & Indiana.  
 T.B.M. - L&T. Top of concrete dyke Nly side of canal. Elev. 842.81  
 Station 10+73.57, Amber Street (proposed).

#### GENERAL NOTES

- Construction shall be in accordance with the City of Riverside Department of Public Works Standard Specifications No. 461 and Standard Drawings.
- Location of laterals to be Determined in the field.
- All laterals to be constructed in accordance with Standard Drawing No. 562.
- Joints in vitrified clay pipe sewer shall conform to A.S.T.M. Standard C-425-60T, or the latest revision thereto.

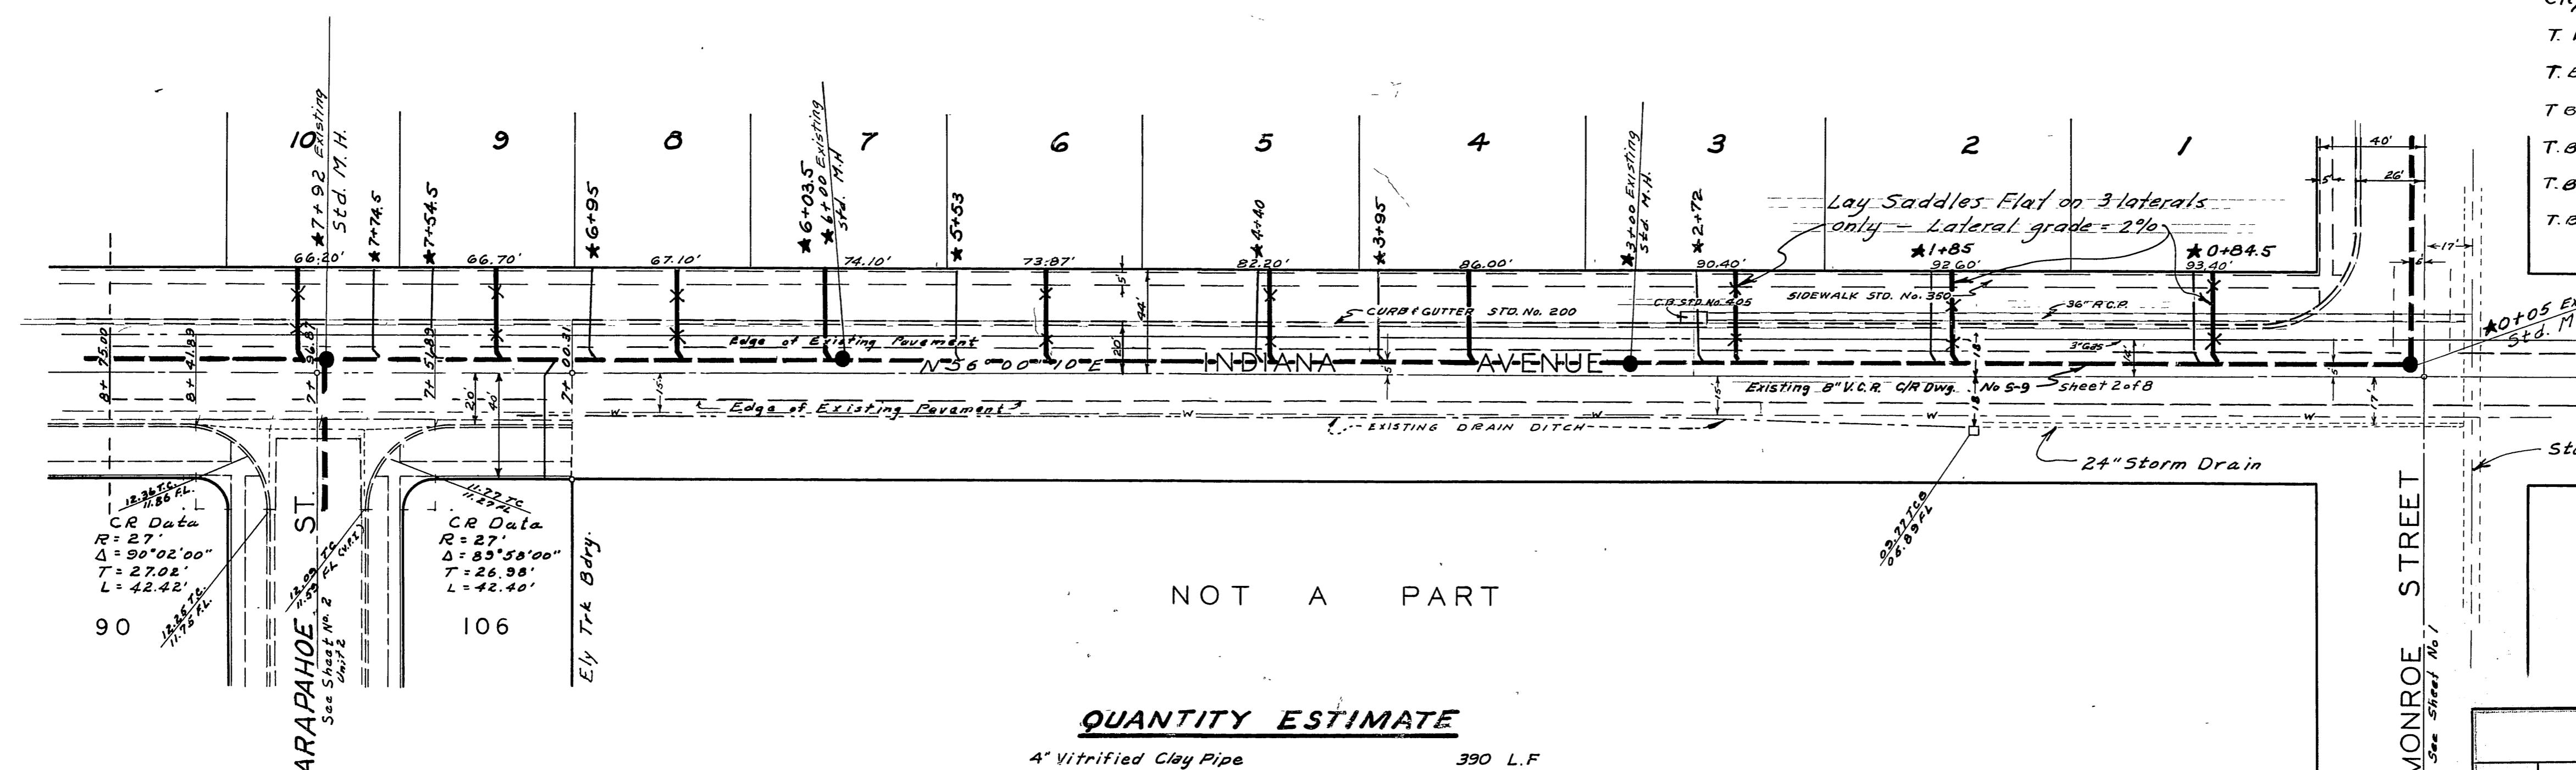

#### QUANTITY ESTIMATE

4" Vitrified Clay Pipe 390 L.F.

Pavement Replacement 140 SF.  
(3" AC over 6" B.M.)

#### NOTE TO CONTRACTOR

The existence and location of any underground utility pipes or structures shown on these plans are obtained by a search of available records. To the best of our knowledge there are no existing utilities except as shown on these plans. The Contractor is required to take due precautionary measures to protect the utility lines shown and any other lines not of record or not shown on these plans.

\* = As Built 9.10.63. G.S.

ALBERT A. WEBB ASSOCIATES  
CIVIL ENGINEERS - RIVERSIDE, CALIFORNIA  
APPROVED *Albert A. Webb* DATE 4/24/63  
RECEIVED *Albert A. Webb* REC'D. 4/24/63

CITY OF RIVERSIDE, CALIFORNIA  
DEPARTMENT OF PUBLIC WORKS

SEWER PLAN & PROFILE

INDIANA AVENUE

TRACT No. 2641

APPROVED BY *Albert A. Webb*

NO. S-412

DATE Aug 7/19/63

SHEET 1 OF 1

DWG. NO. 63-77-B